

1-75 NB FM CR 659/EAGLES LANDING PKWY/HUDSON BRIDGE TO I-675

P. I. NO. 0010126

HENRY COUNTY

UTILITY OWNERS

ALL THE FOLLOWING UTILITY OWNERS WERE REPORTED TO HAVE FACILITIES WITHIN THE VICINITY OF THIS PROJECT AT THE TIME OF THE SUE INVESTIGATION. UTILITIES FOUND WITHIN THE LOS AT THE TIME OF THE SUE INVESTIGATION ARE NOTED FOR EACH UTILITY OWNER LISTED AND ARE SHOWN ON THE PLANS HEREON.

AGL Resources  
(Gas)  
John Gillo  
Engineer  
10 Peachtree PI NE  
Dept.1345 - 11th Floor  
Atlanta,GA 30309  
404-584-3152 of fice  
404-273-0760 mobile  
Note: Located throughout project

AT&T / BellSouth Telecommunications  
(Telephone, Communication)  
Abbreviation - AT&T  
Guy L. Spidel  
GEO MANAGER / SOUTH ATLANTA  
404-532-7571 of fice  
678-575-8982  
Note: Located throughout project

Charter Communication  
(Cable TV, Telecommunication)  
Jason Johnson  
1920 Brannan Rd  
McDonough,GA 30253  
404-732-4786  
Note: Located throughout project

Clayton County Transportation  
(Traffic and Fiber)  
James Lee  
7960 North McDonough Street  
Jonesboro,Georgia 30236  
(770) 477-3674  
Note: Utility owner was contacted and verified that there were no facilities within the LOS of the project

Clayton County Water Authority  
(Water and Sewer)  
Abbreviation - CCWA  
Keith Watkins  
Engineering Coordinator  
1600 Battle Creek Road  
Morrow,GA 30260-4302  
770-960-5204  
dwatkins@ccwa.us  
Note: Located along Walt Stephens Rd and Red Oak Rd

Comcast Cable  
(Cable TV, Telecommunication)  
David Tyson  
9594 Tara Blvd.  
Jonesboro GA 30236  
770-559-6780  
David\_tyson@cable.comcast.com  
Note: Utility owner was contacted and verified that there were no facilities within the LOS of the project

Georgia Department of Transportation  
(Traffic Control)  
Abbreviation - GDOT  
James Gordon  
State ITS Engineer  
935 East Confederate Avenue, SE  
Atlanta,GA 30316-2531  
404-635-806  
Note: Located throughout project

Georgia Power Company  
(Electrical Distribution)  
John Wlsehart  
829 Jefferson Street NW  
Atlanta Georgia 30318  
770-755-6793  
Mobile: 706-662-8422  
jdavis@southernco.com  
Note: Located throughout project

Georgia Power Company  
(Electrical transmission)  
Don St. Clair  
Land Engineering  
241 Ralph McGill Blvd. BIN 10151  
Atlanta, Georgia 30308  
404-506-2644  
X2STCLAI@southernco.com  
Note: Utility owner was contacted and verified that there were no facilities within the LOS of the project

Henry County Water and Sewerage Authority  
(Water and Sewer)  
Fritz Jacques - Engineering Coordinator  
100 Westridge Industrial Blvd  
Madonough, Georgia 30253  
678-583-3824  
Fax: 770-914-3359  
Note: Located throughout project

SUBSURFACE UTILITY ENGINEERING NOTES

- (1) AN OVERHEAD/SUBSURFACE UTILITY ENGINEERING INVESTIGATION (SUE) WAS PERFORMED AND COMPLETED ON 04/15/11 FOR THIS PROJECT. THE EXISTING OVERHEAD AND UNDERGROUND FACILITIES SHOWN HEREON WERE INCLUDED IN THIS SUE INVESTIGATION. THE PRESENCE OF THESE UTILITY FACILITIES HAS BEEN THOROUGHLY INVESTIGATED AND THE METHOD OF DETERMINING THEIR LOCATION IS INDICATED AS SHOWN IN THE PLANS. UTILITIES THAT HAVE BEEN INSTALLED AFTER THE DATE ABOVE HAVE NOT BEEN INCLUDED IN THIS INVESTIGATION AND SHOULD BE CONSIDERED AS FROM RECORD DRAWING ONLY. ALL OTHER EXISTING TOPOGRAPHIC FEATURES DEPICTED HEREON HAVE BEEN REFERENCED FROM A TOPOGRAPHIC / MAPPING SURVEY AND CONTROL PACKAGE PROVIDED BY THE DOT AND DATED 12/22/10. PBS&J/GEL GEOPHYSICS (JV), LLC DOES NOT WARRANT OR CERTIFY THE ACCURACY OR COMPLETENESS OF THE INFORMATION PROVIDED BY THE DOT.
- (2) SUBSURFACE UTILITIES WERE LOCATED USING VISUAL EVIDENCE, GROUND PENETRATING RADAR (GPR) AND RADIO FREQUENCY-ELECTROMAGNETIC (EM) SURVEY. OTHER BURIED UTILITIES MAY EXIST BUT WERE NOT DETECTED DUE TO LIMITATIONS OF GPR AND EM SYSTEMS, SITE ACCESS, AND/OR HIGH UTILITY CONGESTION. THEREFORE, DUE CAUTION SHOULD BE USED WHEN PERFORMING SUBSURFACE EXCAVATION ACTIVITIES WHERE POTENTIAL CONFLICTS EXIST. PBS&J/GEL GEOPHYSICS (JV), LLC WILL NOT BE RESPONSIBLE FOR DAMAGES THAT MAY OCCUR. IDENTIFYING THE LOCATION OF SOME UTILITIES MAY ONLY BE POSSIBLE WITH VACUUM OR OTHER EXCAVATION METHODS.
- (3) WHERE INDICATED, UTILITY PIPE SIZE AND CONSTRUCTION MATERIAL ARE BASED ON VISUAL EVIDENCE OR HISTORICAL RECORDS.
- (4) PRIVATELY OWNED UTILITIES AND TRAFFIC CONTROL SENSORS IN PAVING WERE NOT INCLUDED IN THIS SUE PROJECT.
- (5) SIZE AND MATERIAL TYPE INFORMATION SHOWN HEREON IS TAKEN FROM AVAILABLE UTILITY RECORDS. UNLESS NOTED ON PLANS, ALL SERVICE LINES ARE UNK SIZE/TYPE
- (6) THE EQUIPMENT USED FOR DESIGNATING INCLUDED A MALA GEOSCIENCE X3M GPR, RADIO DETECTION RD4000 AND RD8000 AND A PIPEHORN 900. LEICA SURVEYING INSTRUMENTS WERE USED IN THE DATA COLLECTION.
- (7) UNLESS NOTED ON PLANS, ALL FH CONNECTIONS ARE Q1-D UNK SIZE/TYPE. FH CONNECTIONS WHICH ARE LABELED AS Q1-B ARE ALSO UNK SIZE/TYPE.
- (8) UNLESS NOTED ON PLANS, ALL SERVICE CONNECTIONS (SVC) ARE UNK SIZE/TYPE.

LEGEND

ALL VAULTS SHOWN ARE BASED UPON SURFACE INFORMATION OR UTILITY RECORDS. THE SIZE, LOCATION AND ORIENTATION HAS BEEN DEPICTED TO QUALITY LEVEL "D" (QL-D) UNLESS OTHERWISE NOTED.

ABBREVIATIONS:


EM	ELECTRIC METER
P.E.	POLYETHYLENE
ABD	ABANDONED UTILITY
PLAS.	PLASTIC
STL	STEEL
AC.	ASBESTOS CEMENT
CI	CAST IRON
CONC.	CONCRETE
DI	DUCTILE IRON
RCP	REINFORCED CONCRETE PIPE
F.O.	FIBER OPTIC
FH	FIRE HYDRANT
MET.	METALLIC
F.L.	FLOW LINE
PR	PAIR
PVC	POLYVINYL CHLORIDE
LP	LIGHT POLE
SL	STREET LIGHT
GA	GUY ANCHOR
ELEC.	ELECTRIC
TRANS.	TRANSFORMER
MTD	MULTIPLE TILE DUCT
UNK	UNKNOWN
PED.SIGNAL	PEDESTRIAN CROSSWALK SIGNAL
GALV	GALVANIZED
SVC	SERVICE - UNKNOWN SIZE/TYPE
DLC	DIGITAL LOOP CARRIER
TC BOX	TRAFFIC CONTROL BOX ATTACHED TO UTILITY POLE
SOLAR	SOLAR PANEL ATTACHED TO UTILITY POLE

UNLESS OTHERWISE NOTED ON PLAN SHEETS:

- ALL TRAFFIC CONTROL LINES ARE OWNED BY GEORGIA DEPARTMENT OF TRANSPORTATION
- ALL ELECTRIC DISTRIBUTION LINES ARE OWNED BY GEORGIA POWER COMPANY
- ALL TELEPHONE LINES ARE OWNED BY AT&T
- ALL WATER LINES ARE OWNED BY HENRY COUNTY WATER AND SEWERAGE AUTHORITY
- ALL CABLE TV LINES ARE OWNED BY CHARTER COMMUNICATION
- ALL GAS LINES ARE OWNED BY AGL RESOURCES

**PARSONS**

3577 PARKWAY LANE, SUITE 100  
NORCROSS, GA 30092

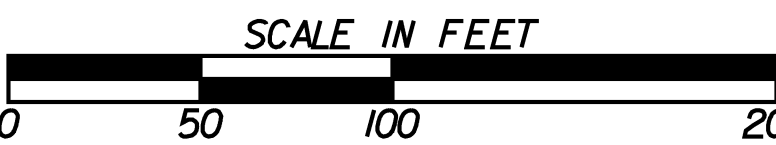

**COSTING PLANS  
FOR DESIGN-BUILD**

REVISION DATES

STATE OF GEORGIA  
DEPARTMENT OF TRANSPORTATION  
OFFICE: INNOVATIVE PROGRAM DELIVERY

**UTILITY PLANS  
NOTES**

1-75  
P. I. 0010126  
TASK ORDER NO. 3

DRAWING No.  
**24-0B**